
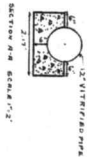
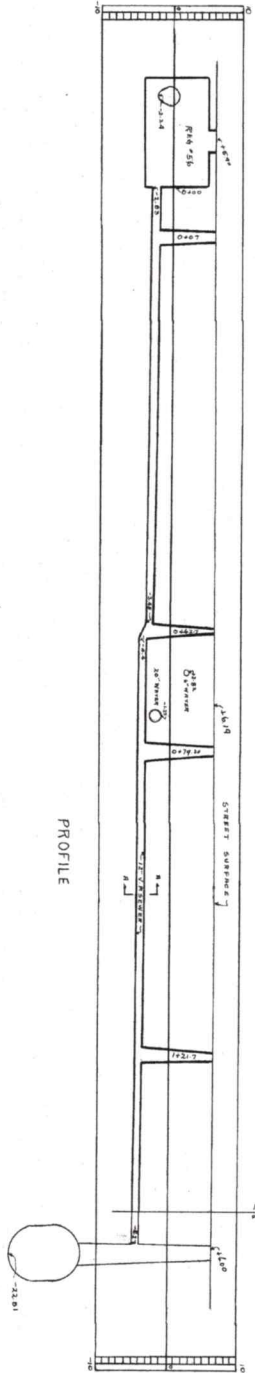


Drawn by J.D.
 CWD by A.S.

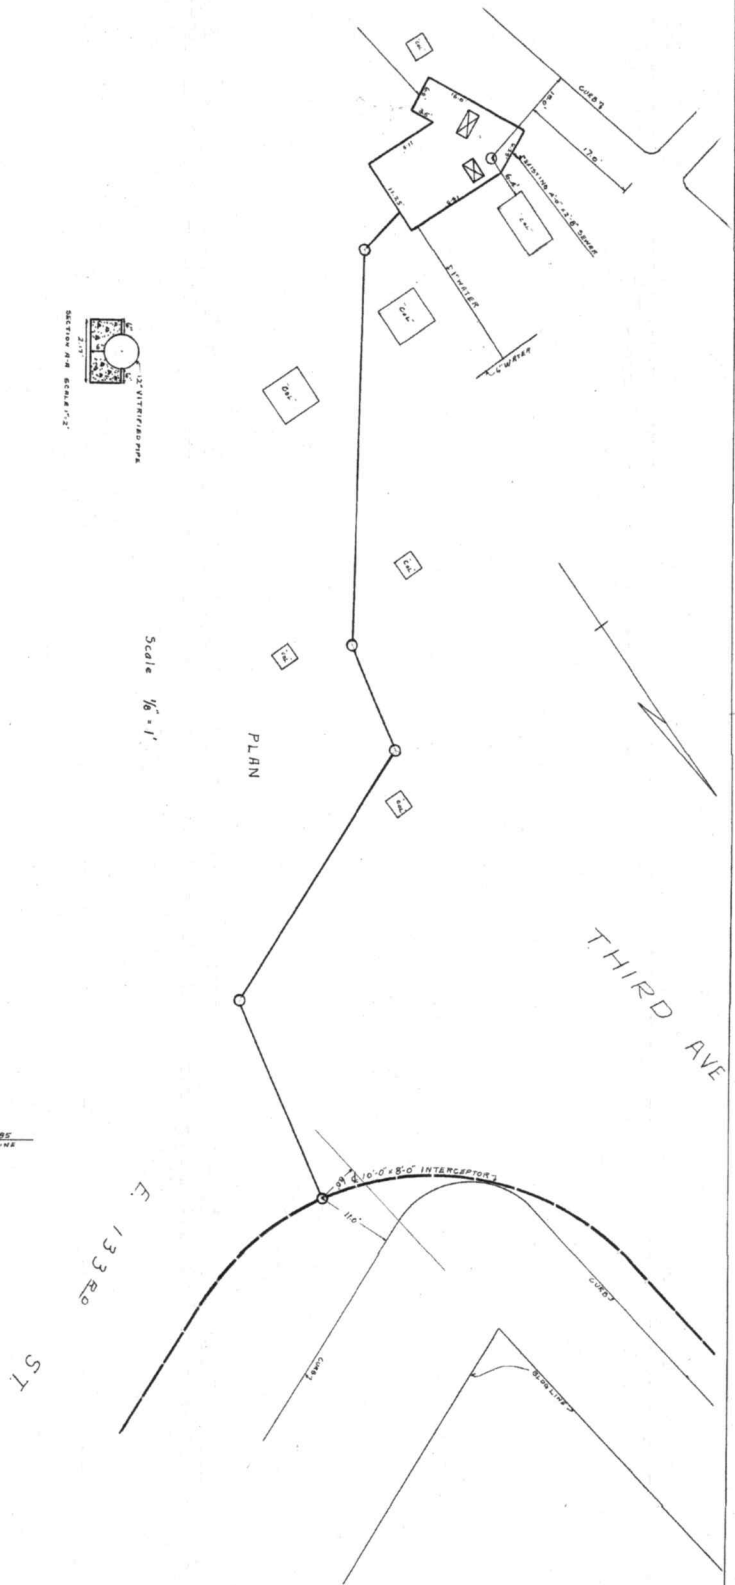

Scale 1/8" = 1'

14385
 HY LINE

14385
 1634
 1580

SCALE: AS SHOWN
 DATE: NOV. 14, 1933

RECORD DRAWING

EJ33 ST & THIRD AVE

CONTRACT 10

SEWERAGE FLOW REGULATOR & BRANCH INTERCEPTORS

References
 Reg Details Dwg 63
 Water System Folio Cowl 10

CITY OF NEW YORK
 DEPARTMENT OF SANITATION
 WARD 5 ISLAND INTERCEPTING SEWERS

DWG. NO. 62
 FILE NO. 10